



Floor Plan


AN AS BUILT FOR:

915 Slocum Street

DALLAS, TX 75207
17,000 SF

3/13/06

SCALE: 1" = 30'-0"

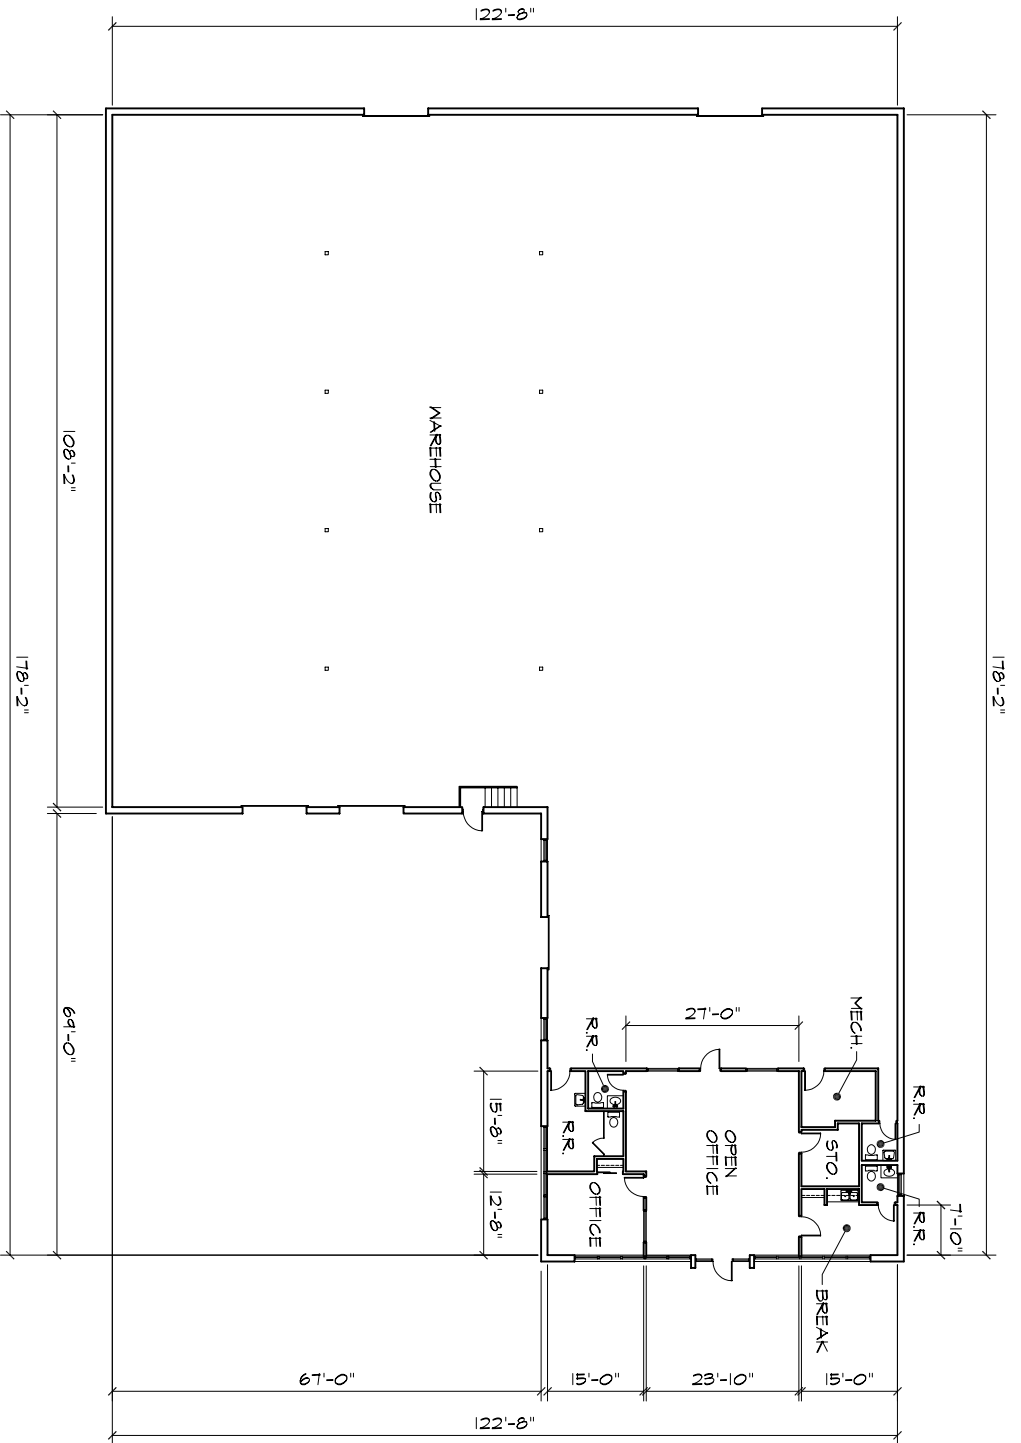

Kevin P. Simon

P.O. Box 100
Mabank, TX 75147
903.880.6636
kevinpsimon@yahoo.com

FOR MORE
INFORMATION
CONTACT:

TOM LUCAS
HARRY B. LUCAS
COMPANY
(972) 991-4567