


SUBMITTED BY

HARRY B. LUCAS COMPANIES

Commercial and Industrial Real Estate

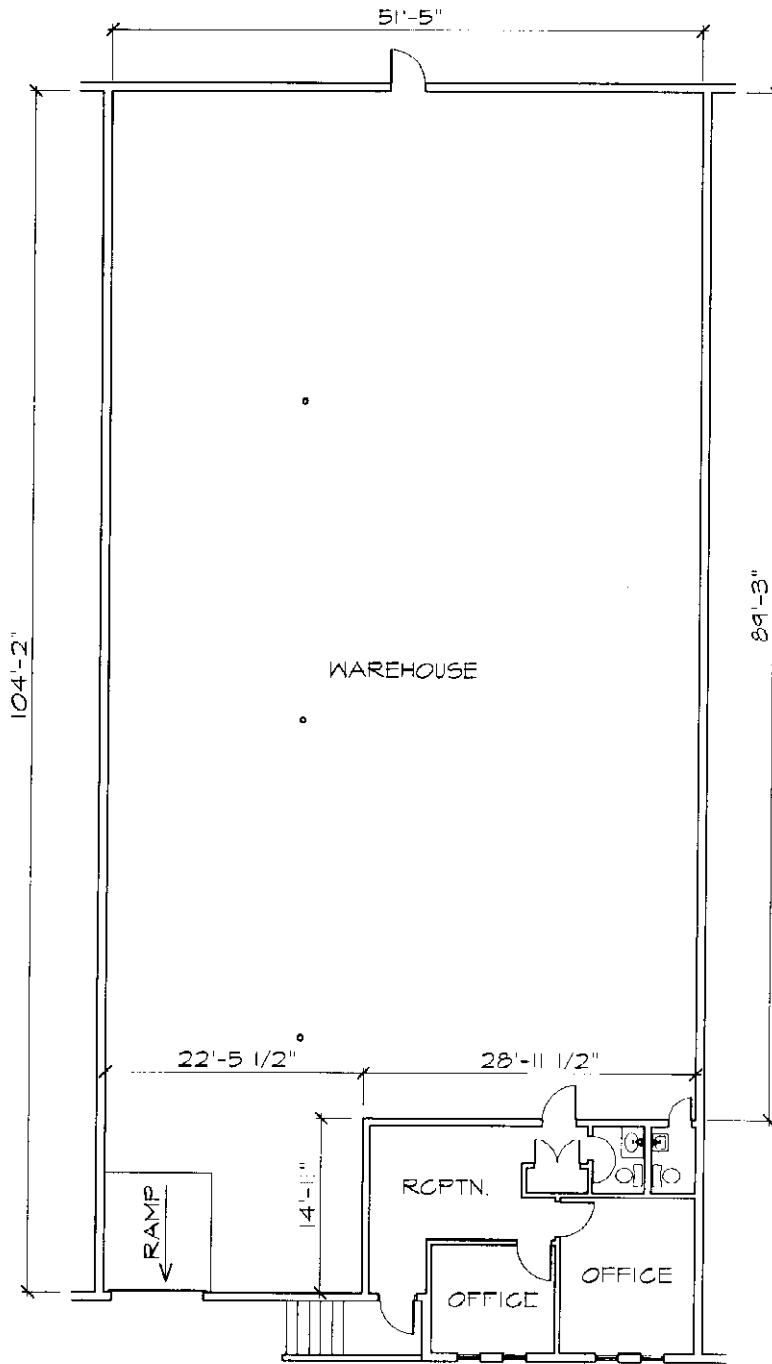

AN AS BUILT FOR: 11/27/02
2425 McIver Lane
 Suite 130
 CARROLLTON, TX 75006
 5,555 SF SCALE: 1/16"=1'-0"

FOR LEASE

FOR MORE INFORMATION CONTACT:
 TOM LUCAS
 HARRY B. LUCAS COMPANY
 (972) 991-4567

Commercial and Industrial Real Estate

Information contained herein has been obtained from the owner of the property & other sources that we deem reliable. We have no reason to doubt its accuracy but we do not guarantee it. This property is subject to prior sale or withdrawal without notice.