


SCALE: 3/32" = 1' 0"

3,984 RSF

# FLOOR PLAN

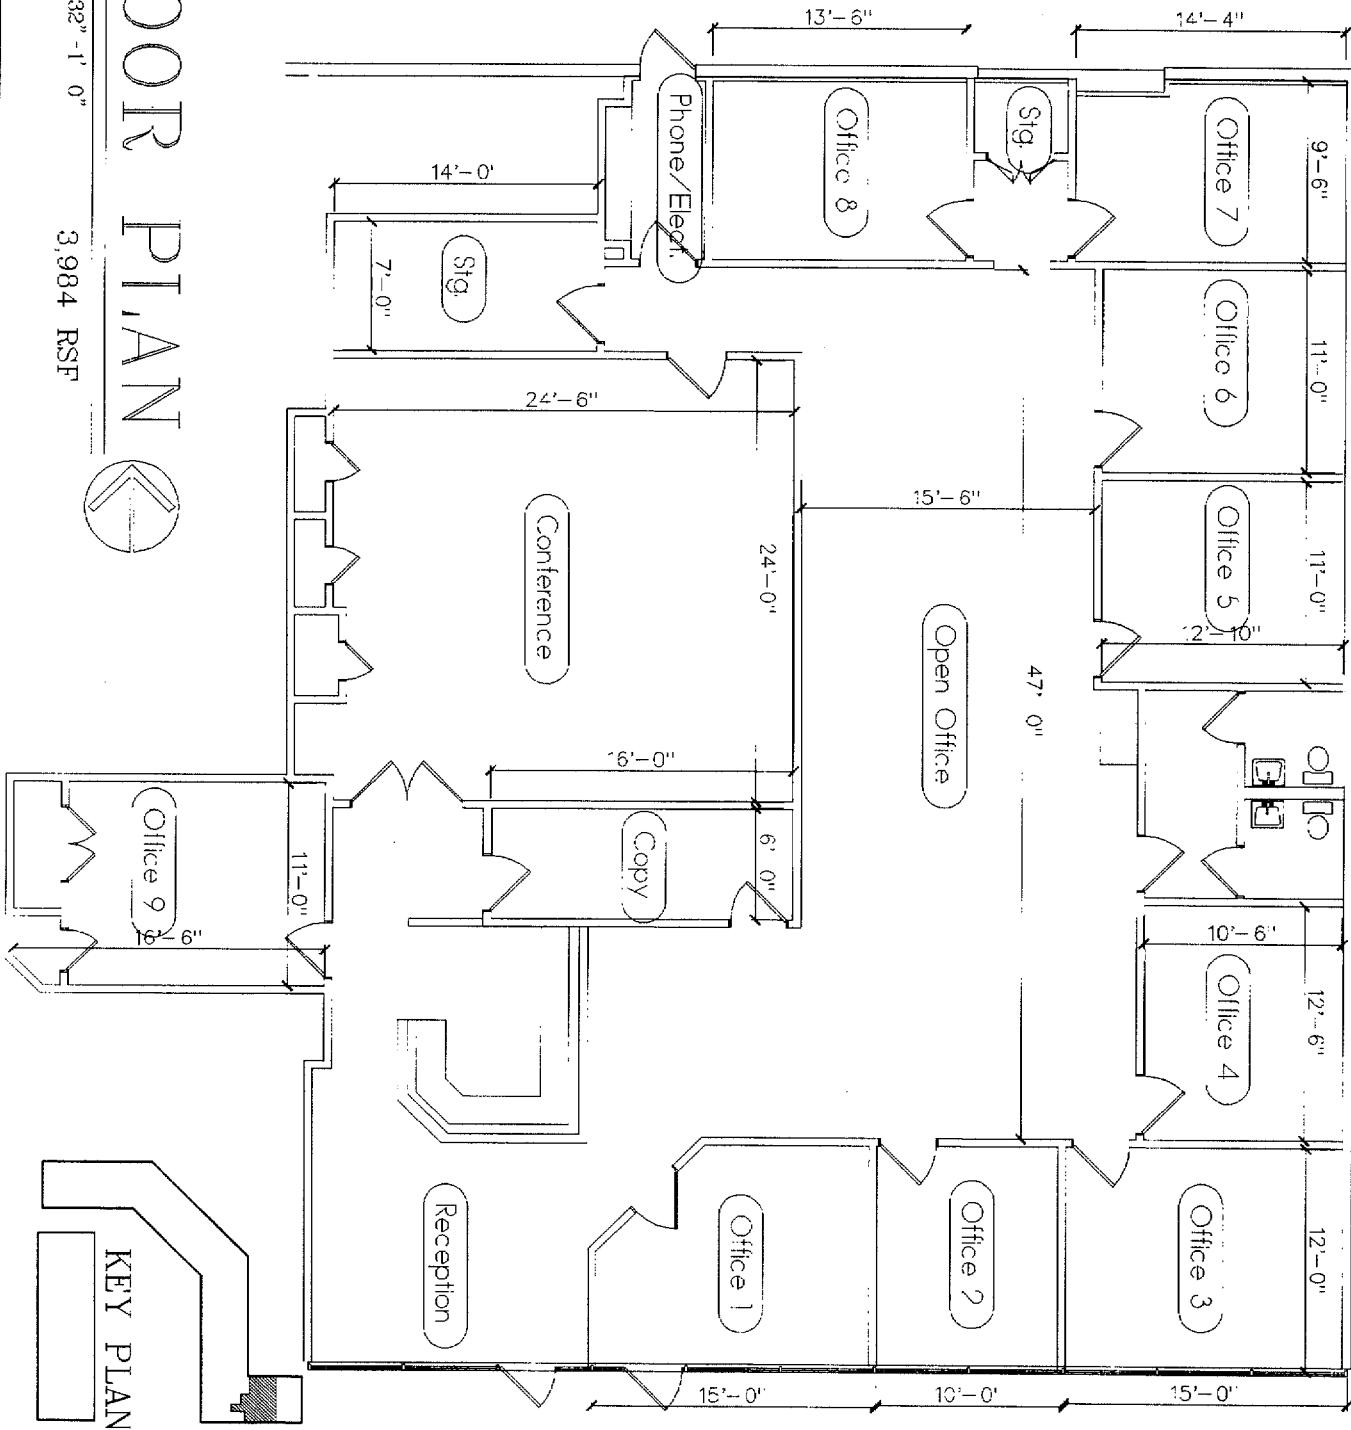

KEY PLAN

FOR MORE INFORMATION CALL TOM LUCAS 972-991-4567

**AS BUILT FOR:  
SUITE: 290**

4885 Alpha  
ALPHA PLAZA  
KENNINGTON PROPERTIES

DATE: 11/21/96



**DESIGNS**  
ARCHITECTURAL PLANNING

1715 GREENWAY  
KAPLAN TOWER  
DALLAS, TEXAS  
(972) 962-4088  
FAX 962-5533

FOR MORE  
INFORMATION  
CONTACT:

**Harry B. Lucas**  
Company  
(972) 991-4567