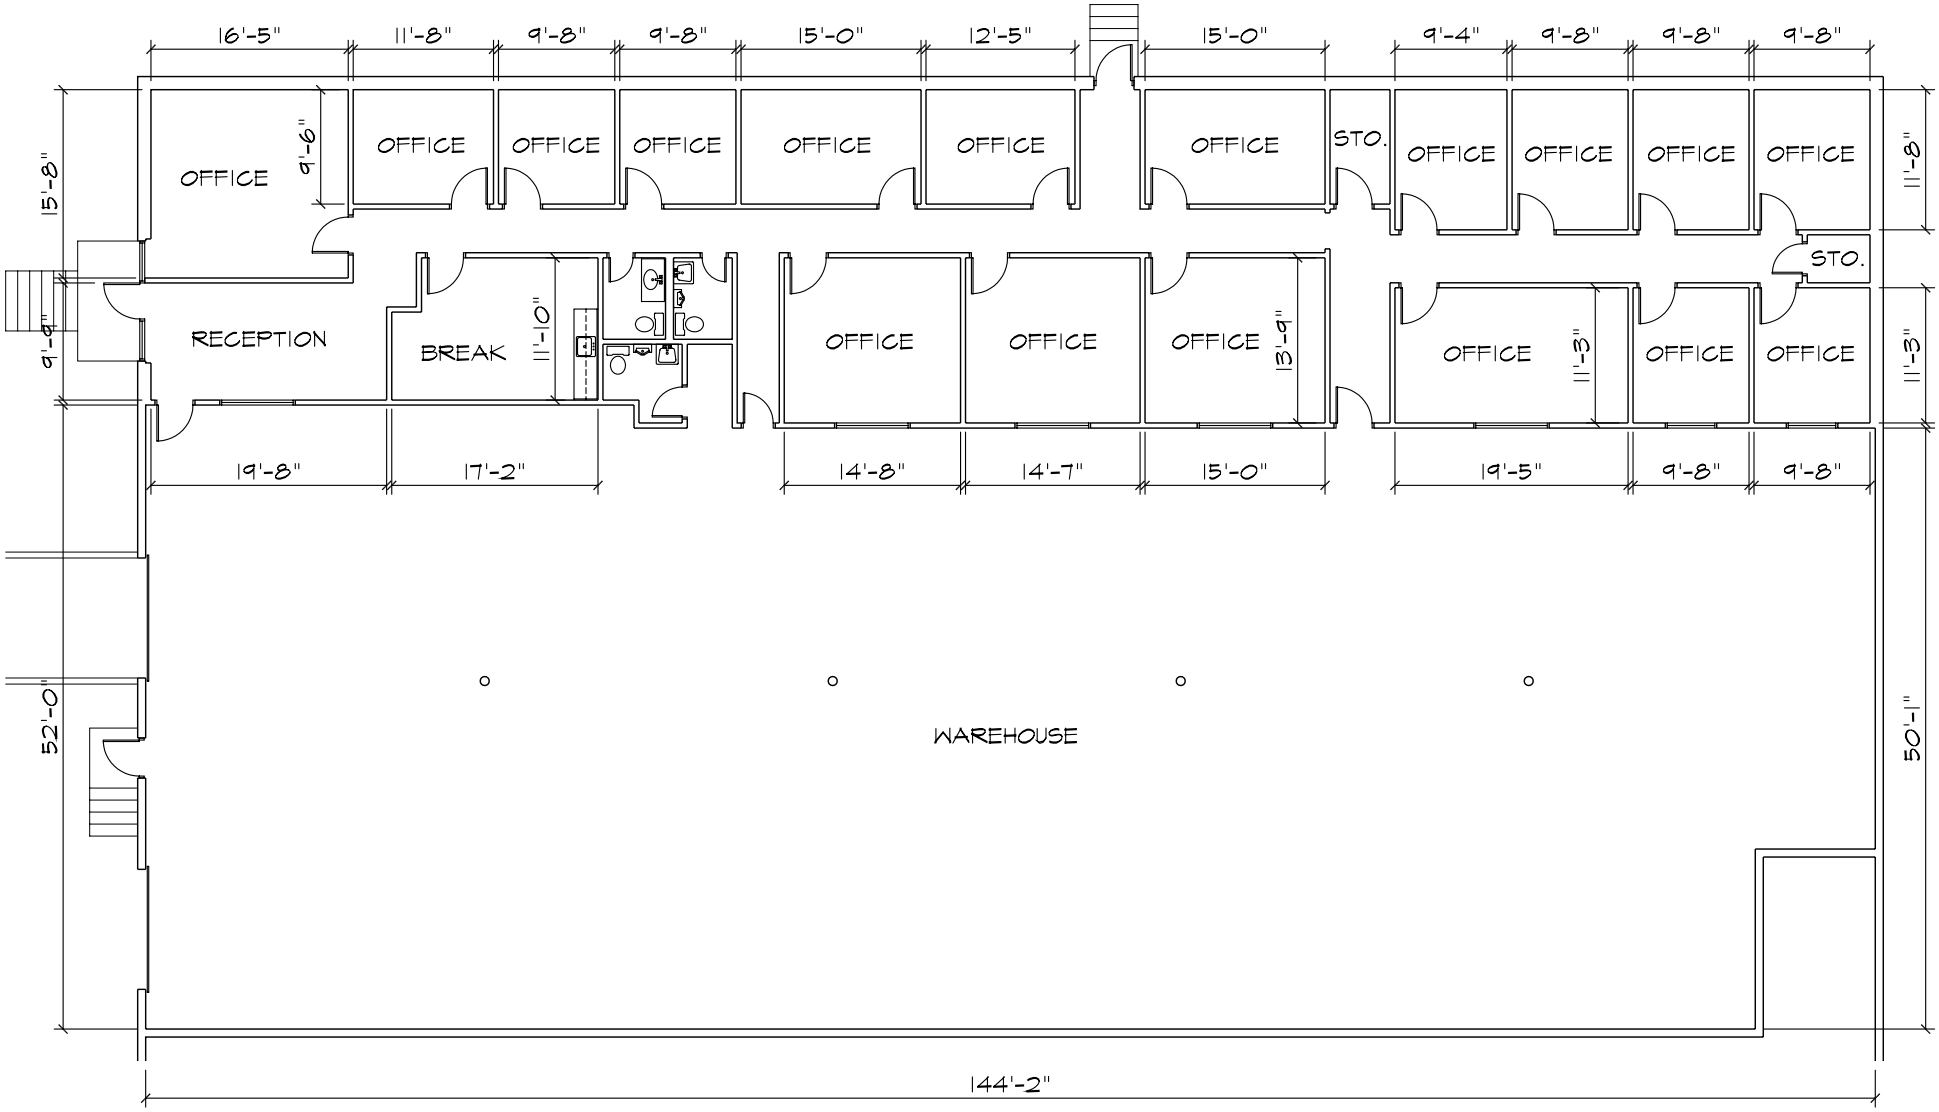

AN AS BUILT FOR: 12/13/04

4010 Billy Mitchell

ADDISON, TX 75001
11,305 SF

SCALE: 1/16" = 1'-0"

Simon Consulting Services

P.O. Box 100
Mabank, TX 75147
903.880.6636

simonconsultingservices@yahoo.com

FOR MORE INFORMATION CONTACT:

TOM LUCAS
RICH YOUNG

HARRY B. LUCAS COMPANY
(972) 991-4567